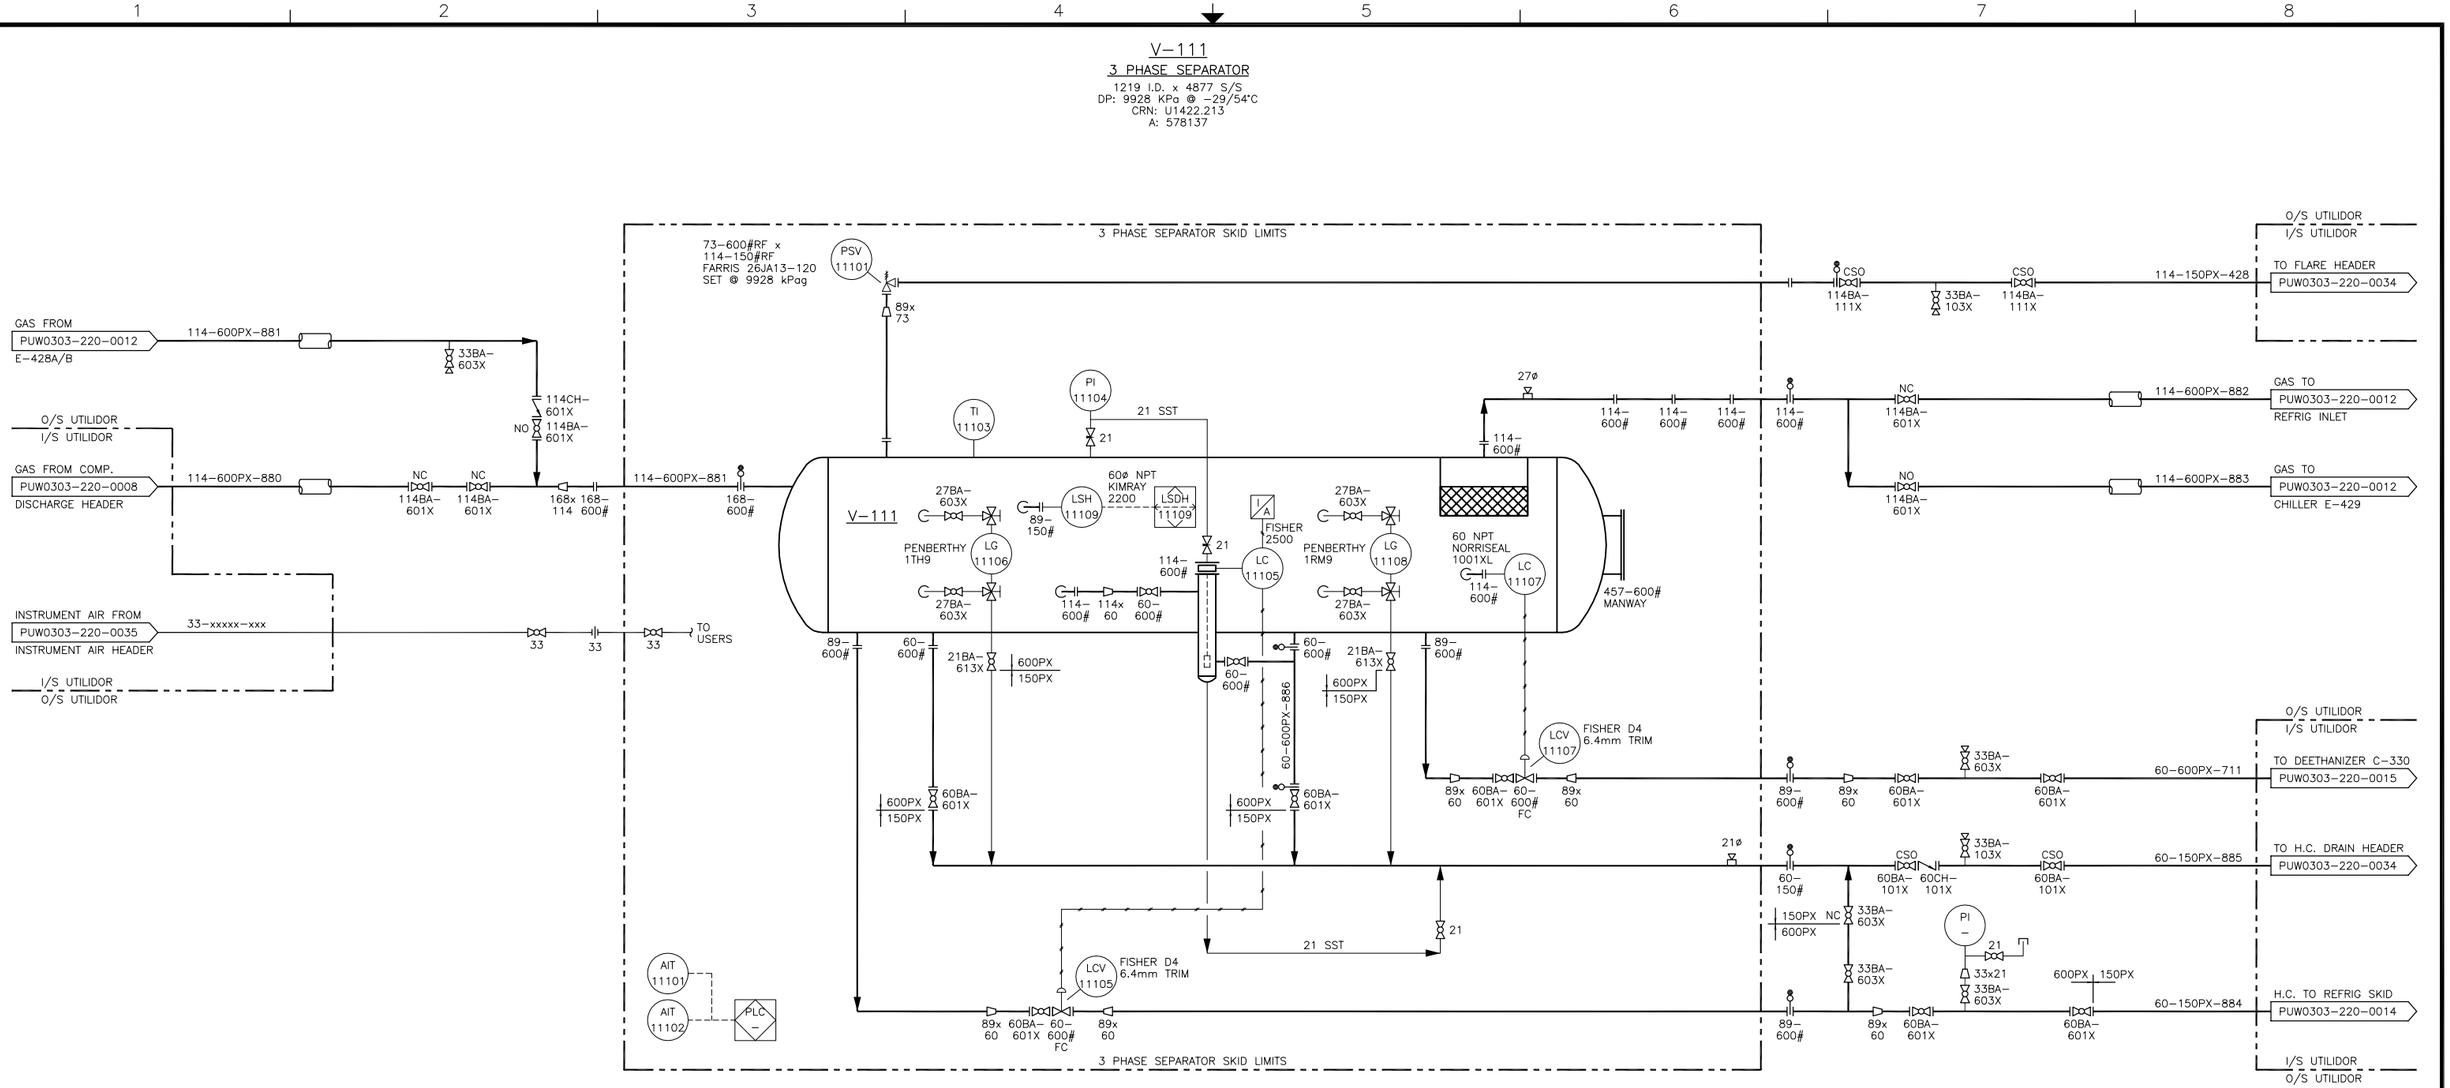

										DRAWN BY: M. FRANCESCONE	DATE 2017-03-15
										DESIGNED BY:	DATE
										CHECKED BY:	DATE
										APPROVED BY:	DATE
54135-MF-00-01	PIPING & INSTRUMENTATION DIAGRAM – SHEET 13		1	PLANT AS-BUILT	MF	2017-07-19	JW	JW		CLIENT BY: B. LAVIGNE	DATE 2017-03-01
DRAWING NO.	REFERENCE DRAWINGS	DRAWINGS PREPARED BY: CANADIAN NATURAL	REV.	DESCRIPTION	BY	DATE	CHK	APP.	CLIENT		

Canadian Natural

TITLE
PUSKWA (1408)
LSD: 03-03-072-26W5M
3 PHASE SEPARATOR V-111
PIPING & INSTRUMENTATION DIAGRAM

SCALE	JOB NO.	DRAWING NO.	REV.
N.T.S.	–	PUW0303-220-0011	1